SOUTHTREE
COMMERCIAL REAL ESTATE

MEDICAL OFFICE FOR LEASE

2080 NEWNAN CROSSING BLVD, NEWNAN, GA 30265

SPACE DETAILS

- 1,708 RSF
- Former Pharmacy space w/ Drive Thru
- Highly Visible to Newnan Crossing Blvd
- Close proximity to Piedmont Newnan Hospital
- Surrounded by numerous other Medical and Retail Tenants
- 0.5 miles to Interstate 85
- 27 Minutes to Hartsfield Jackson Int. Airport

THIS INFORMATION HAS BEEN SECURED FROM SOURCES WE DEEM RELIABLE, BUT WE MAKE NO REPRESENTATIONS OR WARRANTIES, EXPRESSED OR IMPLIED AS TO THE ACCURACY OF THE INFORMATION.

BARRY GARNER
VICE PRESIDENT
770-294-4027
bgarner@stcom.us

SEAN RAWSON
VICE PRESIDENT
678-920-1222
srawson@stcom.us

STCOM.US
770-631-0499
201 PROSPECT PARK, SUITE A,
PEACHTREE CITY, GA 30269

SOUTHTREE
COMMERCIAL REAL ESTATE

AS-BUILT FLOOR PLAN

2080 NEWNAN CROSSING BLVD, NEWNAN, GA 30265

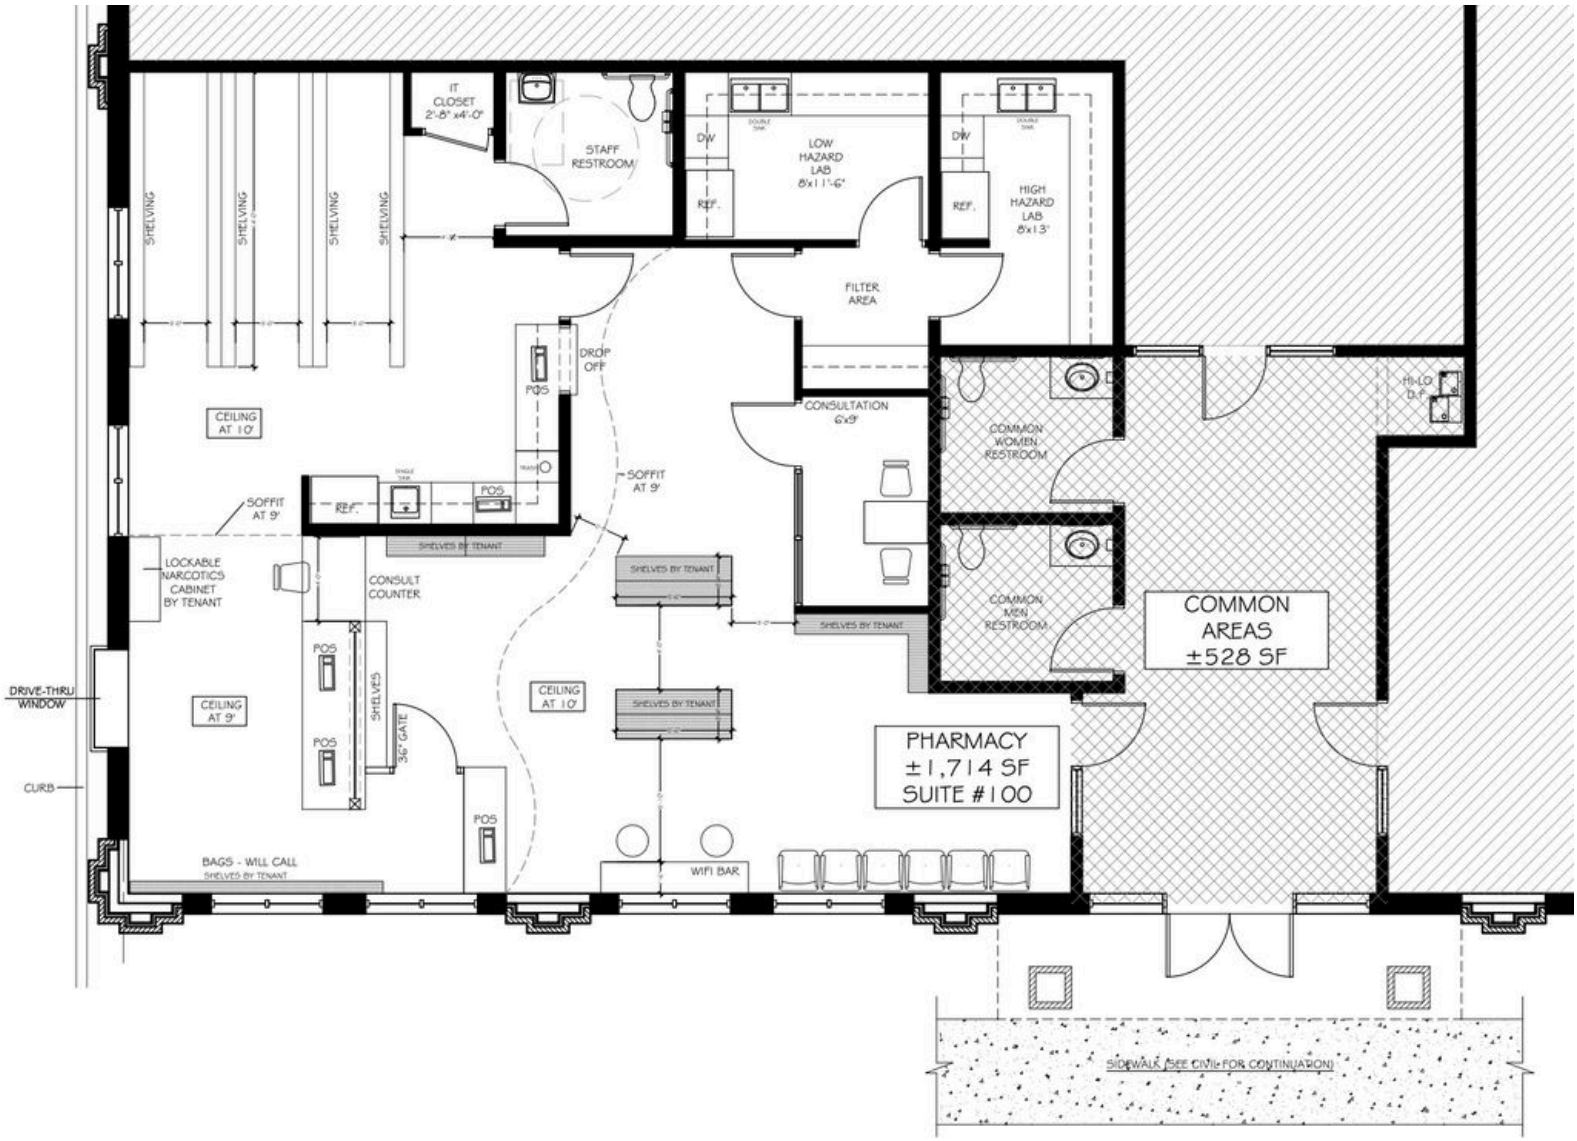

BARRY GARNER
VICE PRESIDENT
770-294-4027
bgarner@stcom.us

SEAN RAWSON
VICE PRESIDENT
678-920-1222
srawson@stcom.us

STCOM.US
770-631-0499
201 PROSPECT PARK, SUITE A, PEACHTREE CITY, GA 30269

SOUTHTREE
COMMERCIAL REAL ESTATE

PROXIMITY MAP

2080 NEWNAN CROSSING BLVD, NEWNAN, GA 30265

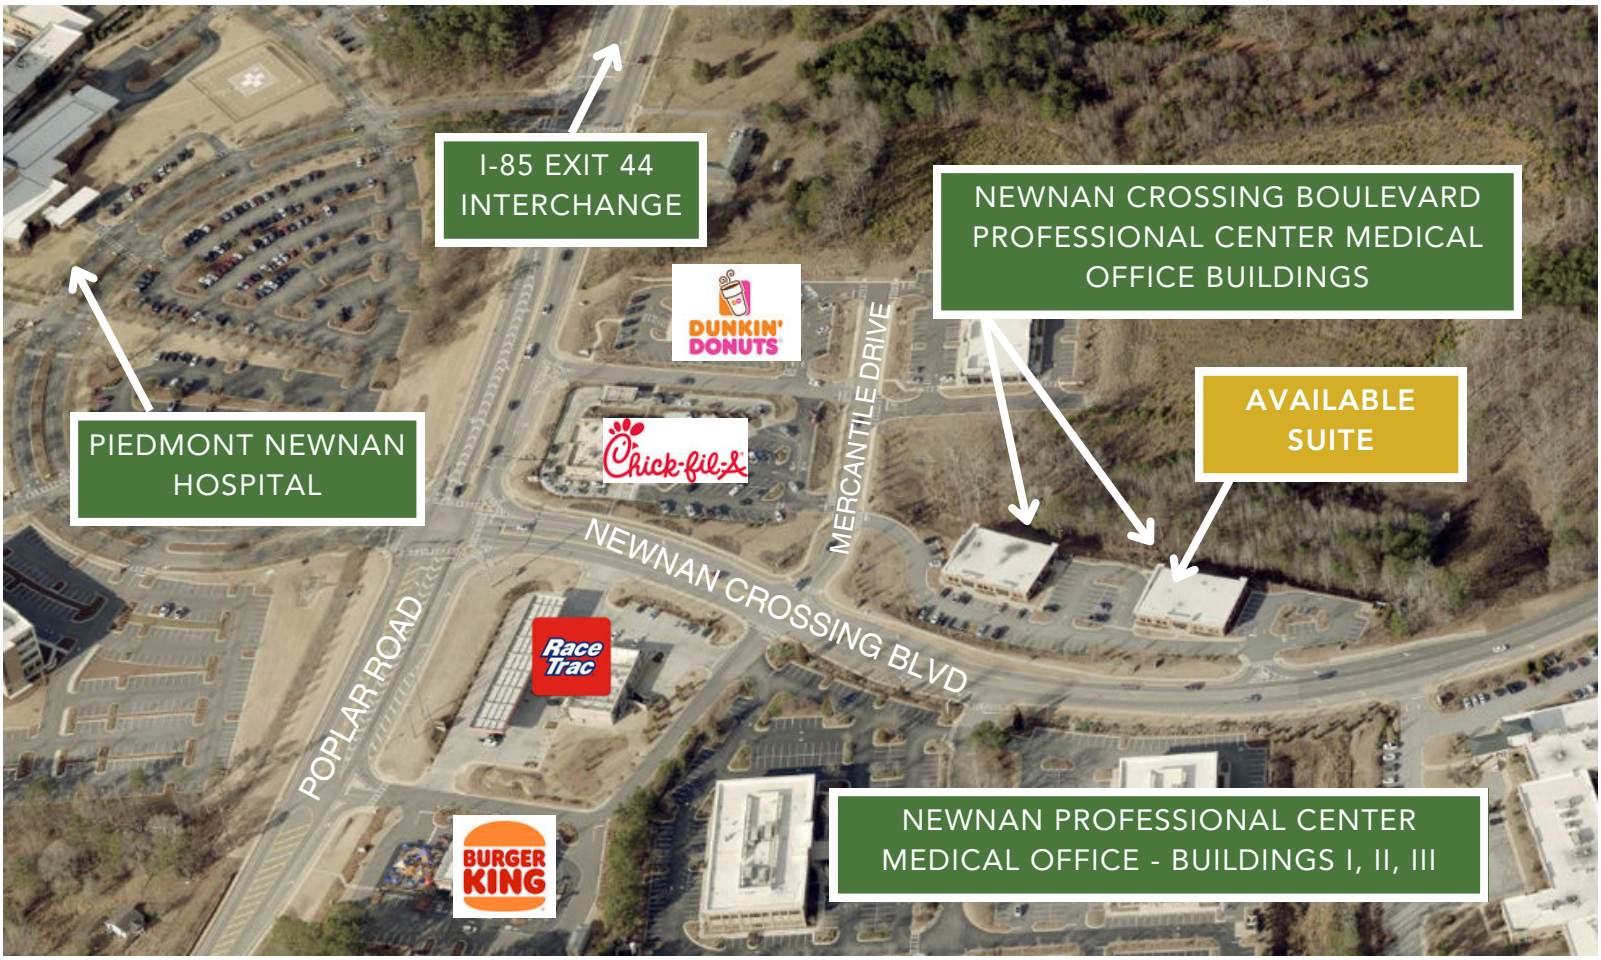

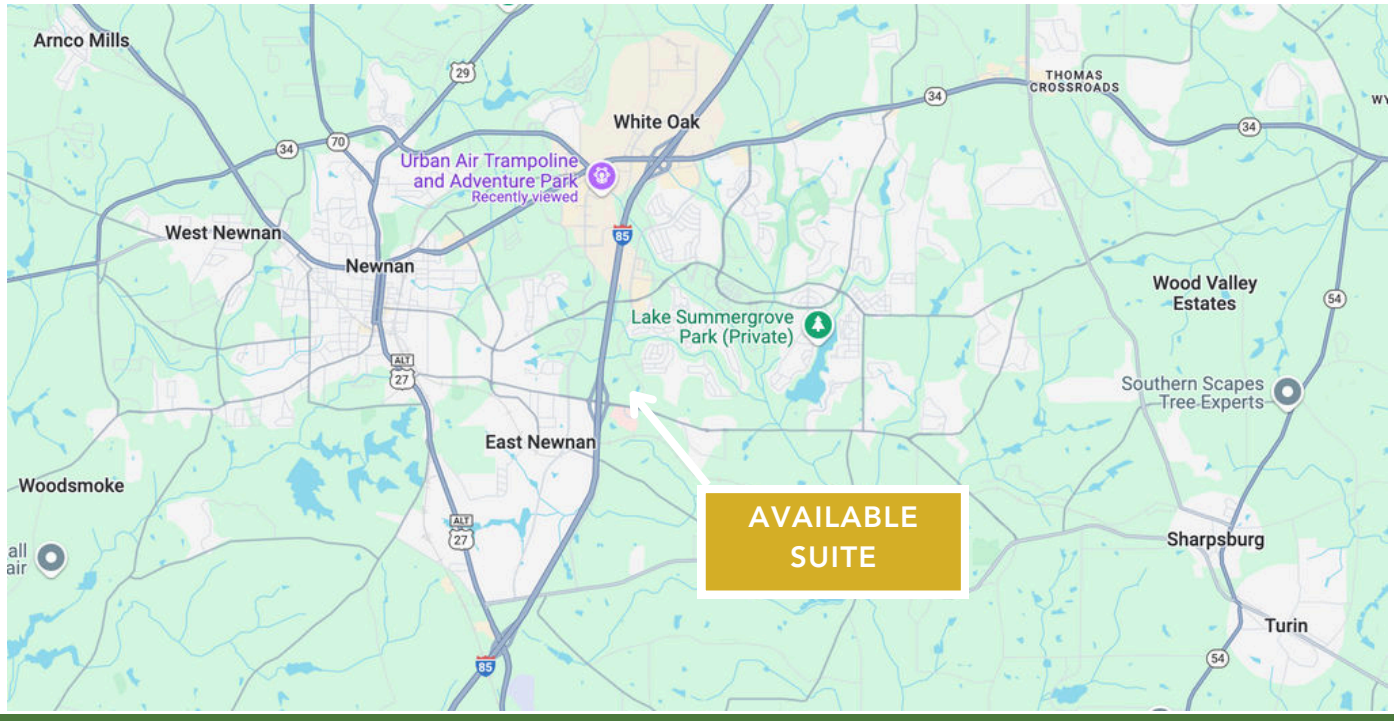

BARRY GARNER
VICE PRESIDENT
770-294-4027
bgarner@stcom.us

SEAN RAWSON
VICE PRESIDENT
678-920-1222
srawson@stcom.us

STCOM.US
770-631-0499
201 PROSPECT PARK, SUITE A, PEACHTREE CITY, GA 30269

SOUTHTREE
COMMERCIAL REAL ESTATE

BUILDING PHOTOS

2080 NEWNAN CROSSING BLVD, NEWNAN, GA 30265

BARRY GARNER
VICE PRESIDENT
770-294-4027
bgarner@stcom.us

SEAN RAWSON
VICE PRESIDENT
678-920-1222
srawson@stcom.us

STCOM.US
770-631-0499
201 PROSPECT PARK, SUITE A, PEACHTREE CITY, GA 30269